PROJECT : 1_Highway_Four_Lane_3D_Plan

As-Built 3D Plan of MLS Survey

Total Length : 1.175 Km

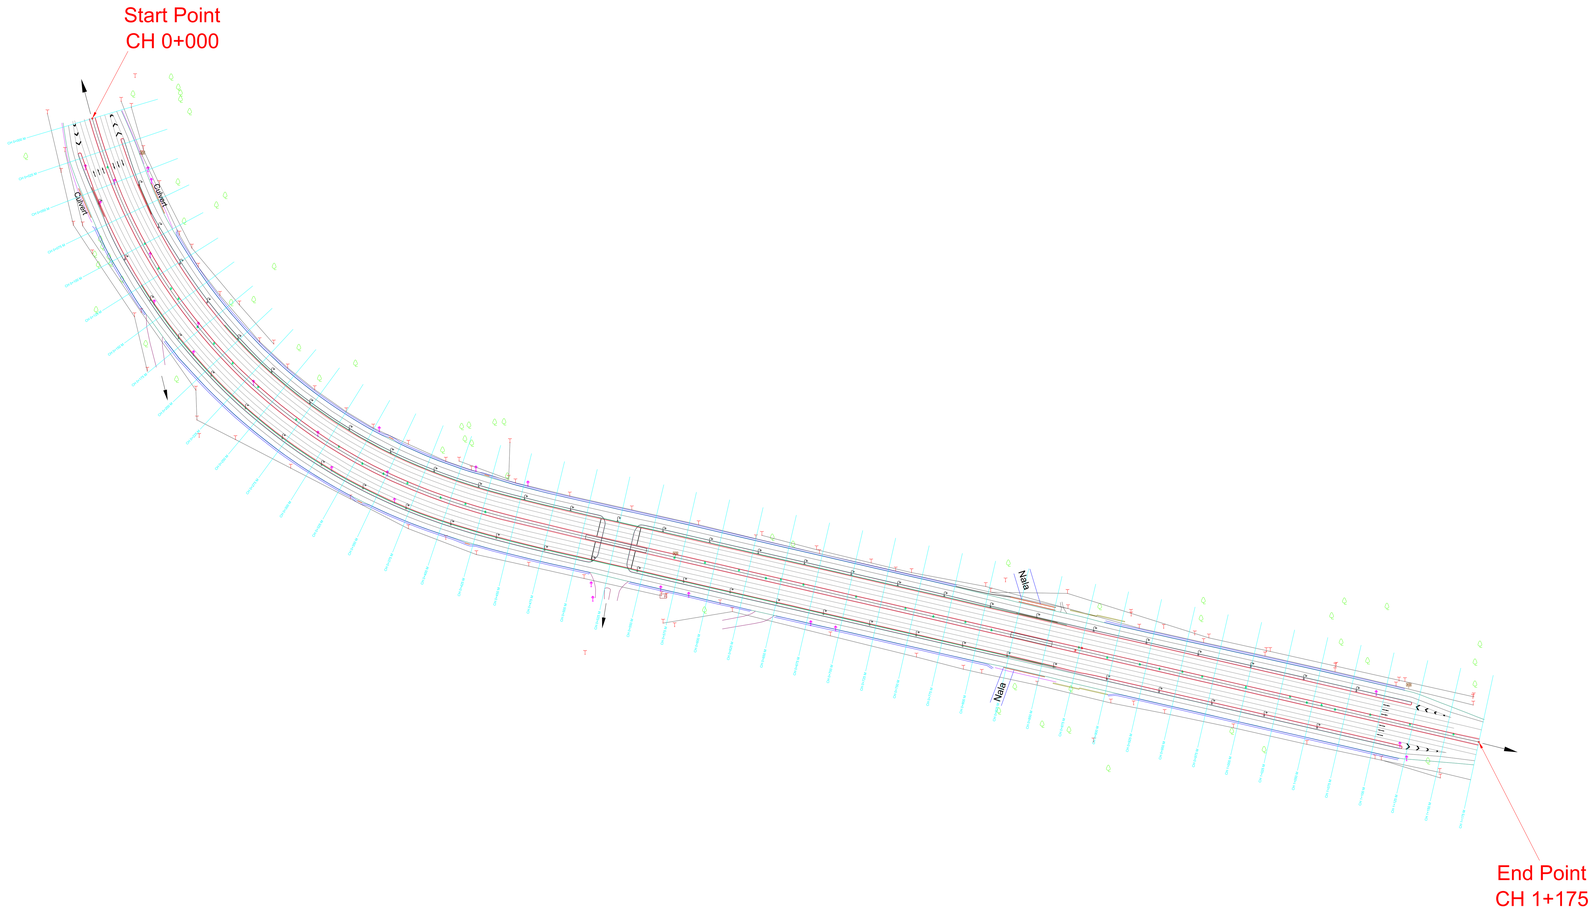

As-Built 3D Plan of :

MOBILE LIDAR SURVEY

North

For 1.175 KM length

Chainage from KM 00/000 TO KM 1/175

LEGEND :

POINT FEATURE			
Electric_Pole, Electric_Transformer, Street_Light.			
Divider_Tree, Kilometer_Stone, Name_Board.			NB
Sign_Board, Tree.			
LINE FEATURE			
Carriageway_Edge, Carriageway_Center, Drainage.			
Service_Road, Road_Junction, Retaining_Wall.			
River_Nala, Flyover_Bridge, Cart_Track_Mud_Road.			
Lane_Marker, Bridge_Culvert, Open_Median.			
Road_Divider, Electric_Line, Crash_Barrier.			
POLYGON FEATURE			
Bank, Building_Kaccha, Building_Pucca, Toilet.			
Chember, College, Hospital, School_Building.			
ANNOTATION			
Place_Name.	•		
Road_Direction.	←		
Start and End Point	Start Point CH 0+000	End Point CH 1+175	
25m_Chainages	CH 1+175 M		

SCALE = 1 : 1000

0 10 20 30 40 50 60 70 80 90 100

metres

PRASHANT ADVANCED SURVEY LLP

O-207, 2nd Floor, Bramha Boulevard Phase 1, CTS 11+12,

Connaught Road, Near Sadhu Vaswani Chowk, Pune 411002.

E-Mail : prashantadvsurvey@gmail.com

Website : www.prashantsurveys.com

Date of Drawing : 01-8-2026.

Drawing Revision No. : 00

File No.: 1_Highway_Four_Lane_3D_Plan