PROJECT : 3_MLS_Road_Single_Lane

As-Built 3D Plan of MLS Survey

Total Length : 1.027 Km

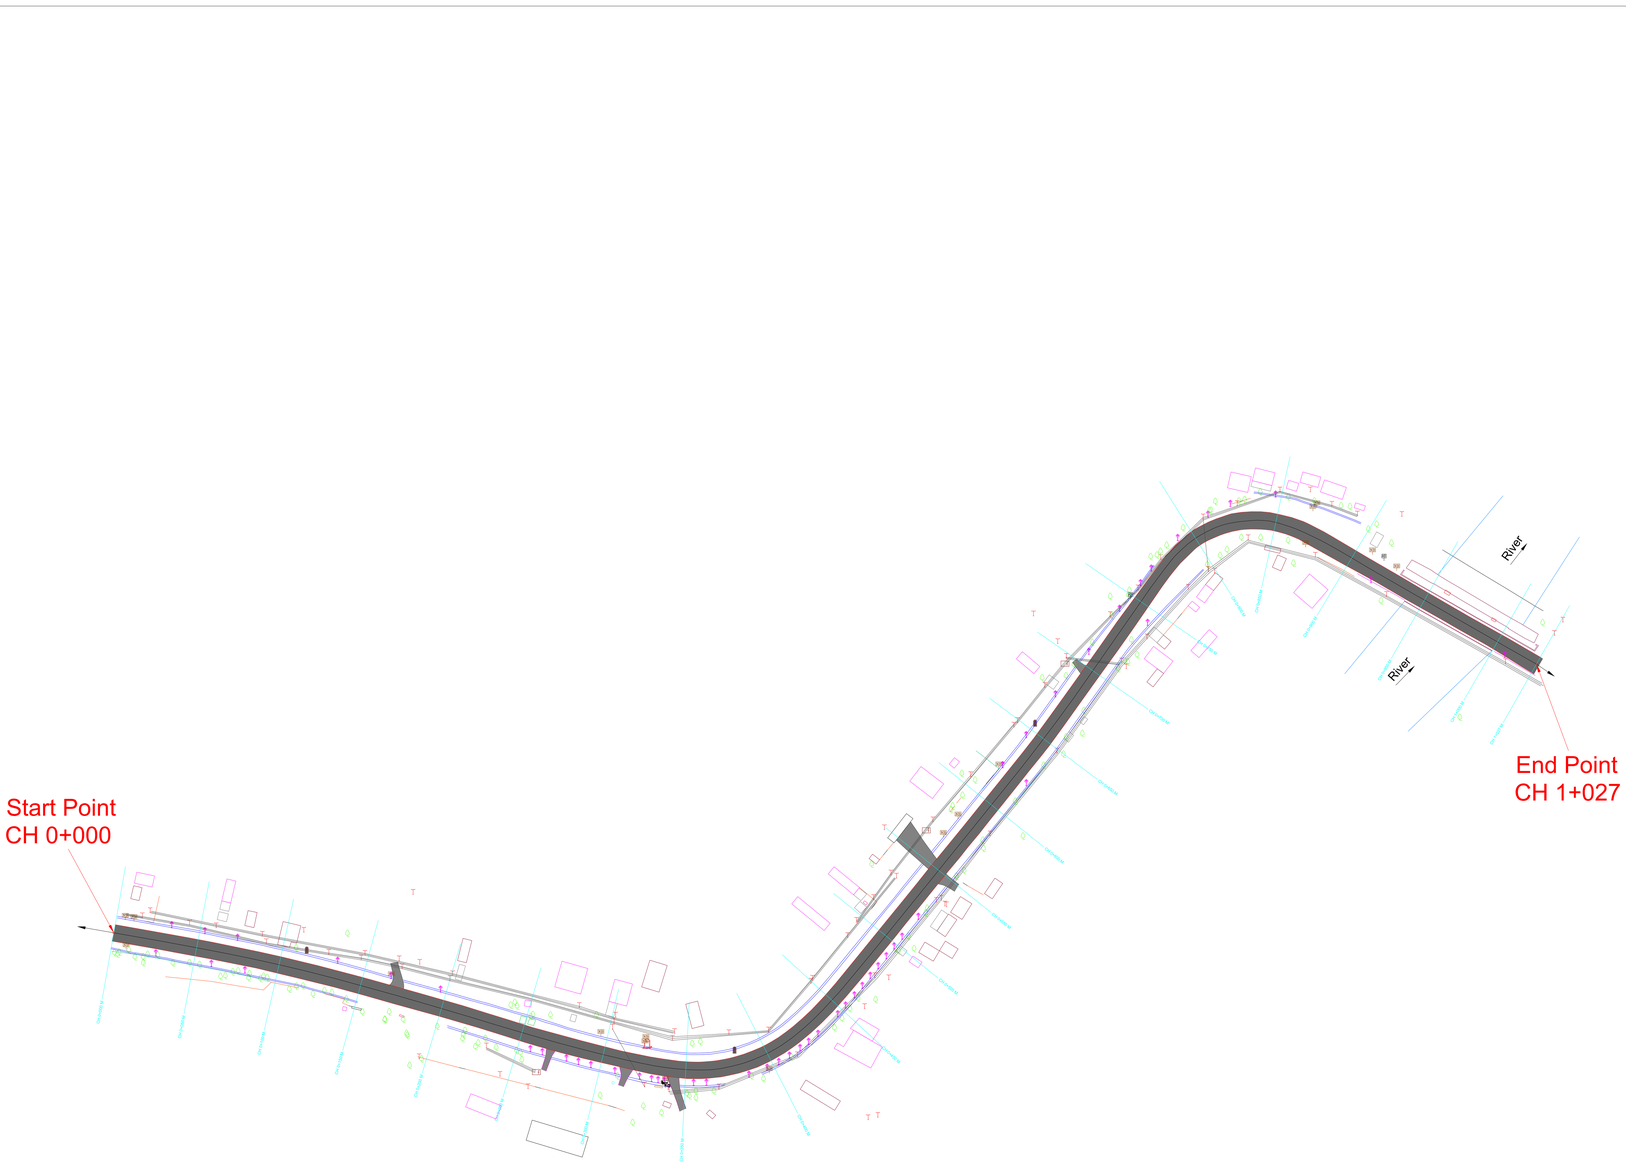

As-Built 3D Plan of :

MOBILE LIDAR SURVEY

North

For 1.027 KM length

Chainage from KM 00/000 TO KM 1/027

LEGEND :

POINT FEATURE			
Electric_Pole, Electric_Transformer, OFC_Stone.			
Advertising_Board, Kilometer_Stone, Name_Board.			
Sign_Board, Tree, CCTV_Camera.			
LINE FEATURE			
Carriageway_Edge, Carriageway_Center, Drainage.			
Cement_Road, Road_Junction, Compound_Wall.			
River_Nala, Crash_Barrier, Cart_Track_Mud_Road.			
Electric_Line, Bridge_Culvert, Gate.			
Pipe_Line, Plinth, Wire_Fence.			
POLYGON FEATURE			
Building_Kaccha, Building_Pucca, Road_Edge_Hatch,			
Other_Road_Hatch, Building_Under_Contruction, Well.			
Bus_Stop, Caman_Welcome_Arch, Police_Station.			
Temple, Tin_Shed, Toilet.			

ANNOTATION		
Start and End Point	Start Point CH 0+000	End Point CH 1+027
Road_Direction.		
50m_Chainages	CH 1+175 M	

SCALE = 1 : 1000

0 10 20 30 40 50 60 70 80 90 100

metres

PRASHANT ADVANCED SURVEY LLP

O-207, 2nd Floor, Bramha Boulevard Phase 1, CTS 11+12,

Connaught Road, Near Sadhu Vaswani Chowk, Pune 411002.

E-Mail : prashantadvsurvey@gmail.com

Website : www.prashantsurveys.com

Date of Drawing : 01-08-2026.

Drawing Revision No. : 00

File No.: 3_MLS_Road_Single_Lane